Beaufort County Public Works



Stormwater Infrastructure Project Summary

Project Summary: Rice Road

Narrative Description of Project:

Completion: Apr-12

Project improved 1,747 L.F. Constructed 136 L.F. of roadside ditch and 130 L.F. of swale. Cleaned out 743 L.F. of roadside ditch. Installed (2) catch basins, (1) crossline pipe, 60 L.F. of outfall pipe, 400 L.F. of roadside pipe, straw mat and rip rap for erosion control. Repaired washout and driveway pipe. Cleaned out (1) catch basin. Jetted (2) driveway pipes and 250 L.F. of roadside pipe. Handseeded and hydroseeded for erosion control.

2011-062 / Rice Road	Labor	Labor	Equipment	Material	Contractor	Indirect	
	Hours	Cost	Cost	Cost	Cost	Labor	Total Cost
ASBUILT / Asbuilt - Project	9.0	\$205.07	\$12.21	\$16.60	\$0.00	\$0.00	\$233.88
AUDIT / Audit Project	2.0	\$40.96	\$0.00	\$0.00	\$0.00	\$0.00	\$40.96
BKFILL / Back Fill	28.0	\$573.44	\$318.25	\$141.79	\$0.00	\$0.00	\$1,033.48
CBIL / Catch Basin - Inlet Lowered	14.0	\$325.79	\$49.49	\$35.80	\$0.00	\$0.00	\$411.08
CLPINS / Crossline Pipe - Installed	60.0	\$1,358.08	\$175.75	\$359.66	\$0.00	\$0.00	\$1,893.49
DPR / Driveway Pipe - Repaired	18.0	\$379.89	\$24.42	\$27.93	\$0.00	\$0.00	\$432.24
ERCON / Erosion control	49.0	\$1,061.62	\$237.45	\$239.59	\$0.00	\$0.00	\$1,538.66
HAUL / Hauling	123.0	\$2,634.66	\$1,637.13	\$1,812.29	\$0.00	\$0.00	\$6,084.08
HYDR / Hydroseeding	6.0	\$120.66	\$37.09	\$174.53	\$0.00	\$0.00	\$332.28
LM / Loading Materials	2.5	\$53.55	\$74.38	\$16.80	\$0.00	\$0.00	\$144.73
LR / Level Road	42.0	\$875.12	\$469.65	\$183.96	\$0.00	\$0.00	\$1,528.73
NONPRO / Non-Professional Services	0.0	\$0.00	\$0.00	\$0.00	\$1,200.00	\$0.00	\$1,200.00
ODCO / Outfall ditch - cleaned out	55.0	\$1,194.75	\$218.30	\$61.11	\$0.00	\$0.00	\$1,474.16
ODCON / Outfall ditch - constructed	42.0	\$899.50	\$292.30	\$101.99	\$0.00	\$0.00	\$1,293.79
ODGRB / Outfall ditch - grubbed	150.0	\$3,300.42	\$637.12	\$270.27	\$0.00	\$0.00	\$4,207.81
OFPI / Outfall Pipe - Installation	214.0	\$4,858.54	\$1,168.75	\$4,885.41	\$0.00	\$0.00	\$10,912.70
PRRECON / Project Reconnaissance	24.0	\$541.82	\$48.84	\$41.56	\$0.00	\$0.00	\$632.22
RSPJ / Roadside Pipe - Jetted	10.0	\$218.80	\$110.80	\$82.12	\$0.00	\$0.00	\$411.72
UTLOC / Utility locates	3.0	\$61.44	\$4.07	\$0.00	\$0.00	\$0.00	\$65.51
WSDR / Workshelf - Dressed	10.0	\$204.80	\$82.70	\$25.54	\$0.00	\$0.00	\$313.04
Indirect Labor, Services and Supplies	0.0	\$0.00	\$0.00	\$0.00	\$0.00	\$12,908.14	\$12,908.14
2011-062 / Rice Road	861.5	\$18,908.91	\$5,598.70	\$8,476.94	\$1,200.00	\$12,908.14	\$47,092.68
Sub Total							
Grand Total	861.5	\$18,908.91	\$5,598.70	\$8,476.94	\$1,200.00	\$12,908.14	\$47,092.68










Beaufort County Public Works





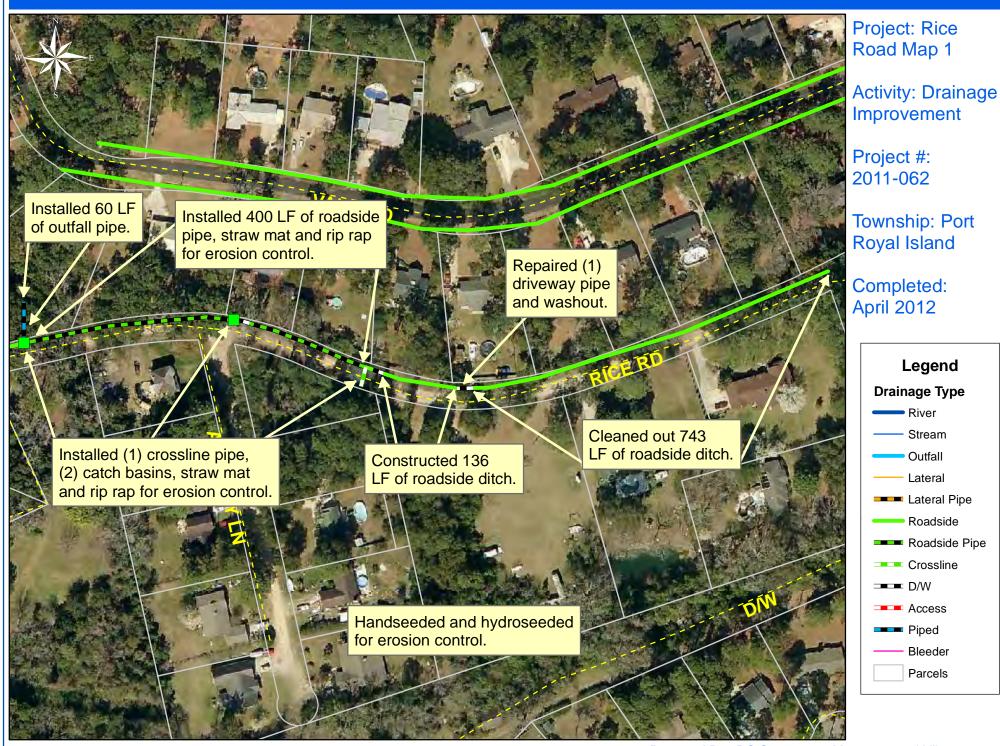


50 100 200 300

400 Feet

1 inch = 141 feet

Prepared By: BC Stormwater Management Utility Date Print: 4/17/12 File:C:/sethdata/projects/projectmaps/Rice Rd 11-062 Map1

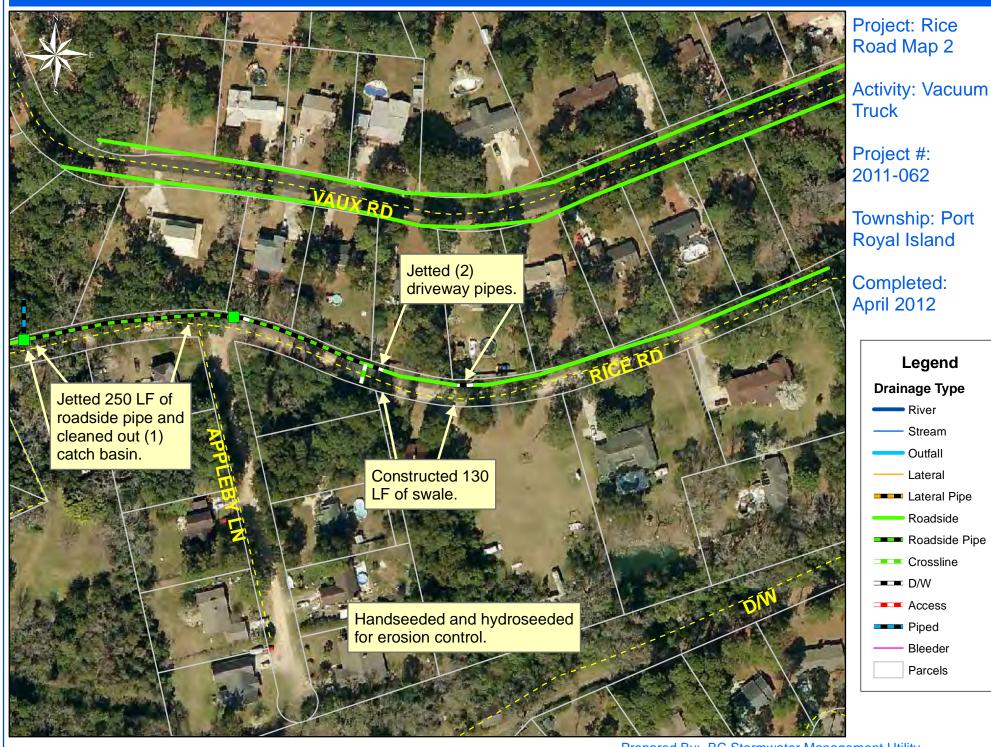

Prepared By: BC Stormwater Management Utility Date Print: 4/17/12 File:C:/sethdata/projects/projectmaps/Vac/Rice Rd 11-062 Map2

200

100

50

400 Feet

300

1 inch = 141 feet