



# Beaufort County Public Works Stormwater Infrastructure Project Summary

**Project Summary:** Huron Drive

**Activity:** Routine/Preventive Maintenance

**Narrative Description of Project:**

Project improved 228 L.F. of drainage system. Installed (1) catch basin, 228 L.F. of channel pipe, rip rap and hydroseeded for erosion control.

**Completion:** Nov-14

2015-005 / Huron Drive	Labor Hours	Labor Cost	Equipment Cost	Material Cost	Contractor Cost	Indirect Labor	Total Cost
ASBUILT / Asbuilt - Project	2.0	\$88.54	\$7.24	\$5.82	\$0.00	\$67.92	\$169.52
AUDIT / Audit Project	0.5	\$10.23	\$0.00	\$0.00	\$0.00	\$6.62	\$16.85
BKFILL / Back Fill	13.0	\$265.98	\$113.06	\$50.33	\$0.00	\$171.99	\$601.36
CBIR / Catch Basin - Inlet Raised	77.0	\$1,654.44	\$156.50	\$257.91	\$0.00	\$1,046.61	\$3,115.45
ESTP / Estimating Project	8.0	\$354.16	\$0.00	\$0.00	\$0.00	\$271.68	\$625.84
HAUL / Hauling	96.5	\$2,113.40	\$925.55	\$1,430.63	\$0.00	\$1,414.13	\$5,883.71
HYDR / Hydroseeding	12.0	\$274.72	\$39.36	\$147.57	\$0.00	\$173.40	\$635.05
OFPI / Channel Pipe - Installation	190.0	\$4,136.52	\$471.07	\$3,423.92	\$0.00	\$2,616.80	\$10,648.31
ONJV / Onsite Job Visit	49.0	\$1,505.45	\$206.34	\$80.73	\$0.00	\$940.46	\$2,732.98
PROFS / Professional Services	0.0	\$0.00	\$0.00	\$0.00	\$64.56	\$0.00	\$64.56
STAGING / Staging Materials	30.0	\$667.71	\$140.12	\$80.61	\$0.00	\$417.05	\$1,305.49
UTLOC / Utility locates	0.5	\$10.23	\$0.00	\$0.00	\$0.00	\$6.62	\$16.85
<b>2015-005 / Huron Drive Sub Total</b>	<b>478.5</b>	<b>\$11,081.38</b>	<b>\$2,059.24</b>	<b>\$5,477.52</b>	<b>\$64.56</b>	<b>\$7,133.27</b>	<b>\$25,815.97</b>
 <b>Grand Total</b>	 <b>478.5</b>	 <b>\$11,081.38</b>	 <b>\$2,059.24</b>	 <b>\$5,477.52</b>	 <b>\$64.56</b>	 <b>\$7,133.27</b>	 <b>\$25,815.97</b>

Before




During



After



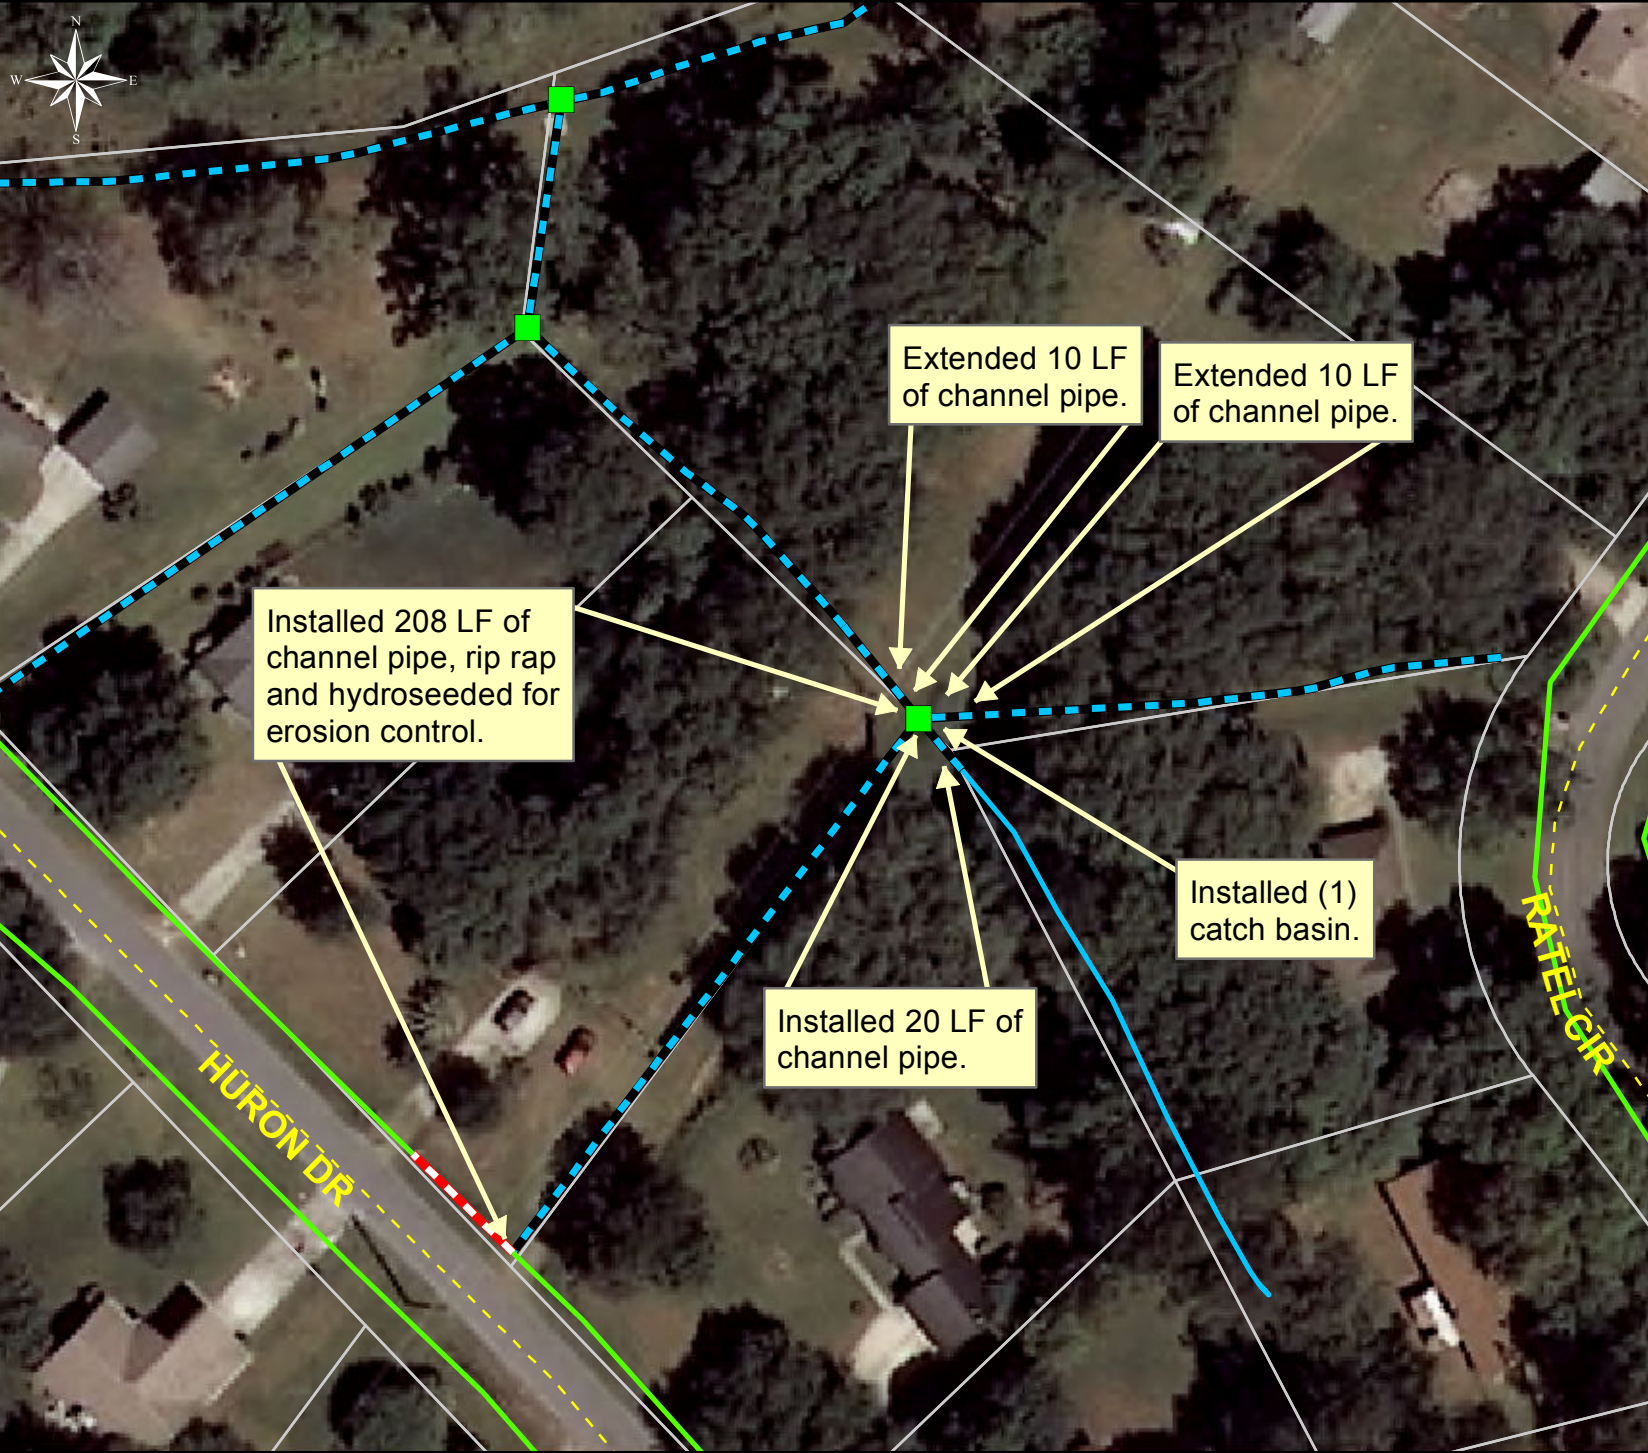

**Project: Huron Drive**

**Activity: Drainage Improvement**
















**Project #:  
2015-005**

**Township: Port Royal Island**

**Completed:  
November 2014**

**Legend**

**TYPE**

-  River
-  Creek/Stream
-  River/Creek/Marsh BANK
-  Channel (fka Outfall)
-  Channel Pipe
-  Lateral
-  Lateral Pipe
-  Roadside
-  Roadside Pipe
-  Road Pipe
-  Crossline Pipe
-  Driveway Pipe
-  Access Pipe
-  Bleeder Pipe
-  Catch Basin

0 15 30 60 90 120 Feet

**1 inch = 65 feet**

Prepared By: BC Stormwater Management Utility

Date Print: 12/29/14

File: C:/sethdata/projects/projectmaps/Huron Dr 2015-005